

**ASBUILT PLAN**  
 - TOWN OF MILBURY -  
 ATHLETIC CAMPUS RENOVATIONS


12 MARTIN STREET  
 MILBURY, MASSACHUSETTS

**Green Acres**  
 LANDSCAPE & CONSTRUCTION  
 CO. INC.

21 MALBONE STREET  
 LAKEVILLE, MA. 02347  
 PHONE (508) 823-6699 FAX (508) 823-7502  
 www.greenacresinc.com

SCALE 1" = 30' DATE 2/9/21 SHEET 1 OF 2

- LEGEND**
- 180x4 ASBUILT SPOT GRADE
  - ASBUILT TOPOGRAPHY
  - ASBUILT FENCE
  - ASBUILT SIGN
  - ASBUILT BOLLARD
  - ASBUILT CATCHBASIN
  - ASBUILT DRAIN MANHOLE
  - ASBUILT SEWER MANHOLE
  - ASBUILT IRRIGATION HEAD
  - ASBUILT IRRIGATION HEAD
  - ASBUILT IRRIGATION CONTROL BOX
  - ASBUILT WELL
  - ASBUILT ATHLETIC LIGHTING
  - ASBUILT UTILITY POLE
  - ASBUILT LIGHT POLE
  - ASBUILT UNDERGROUND ELECTRIC
  - ASBUILT ELECTRIC HAND HOLE
  - ASBUILT TREE
  - ASBUILT LANDSCAPE
  - ASBUILT ROCK
  - ASBUILT BENCH

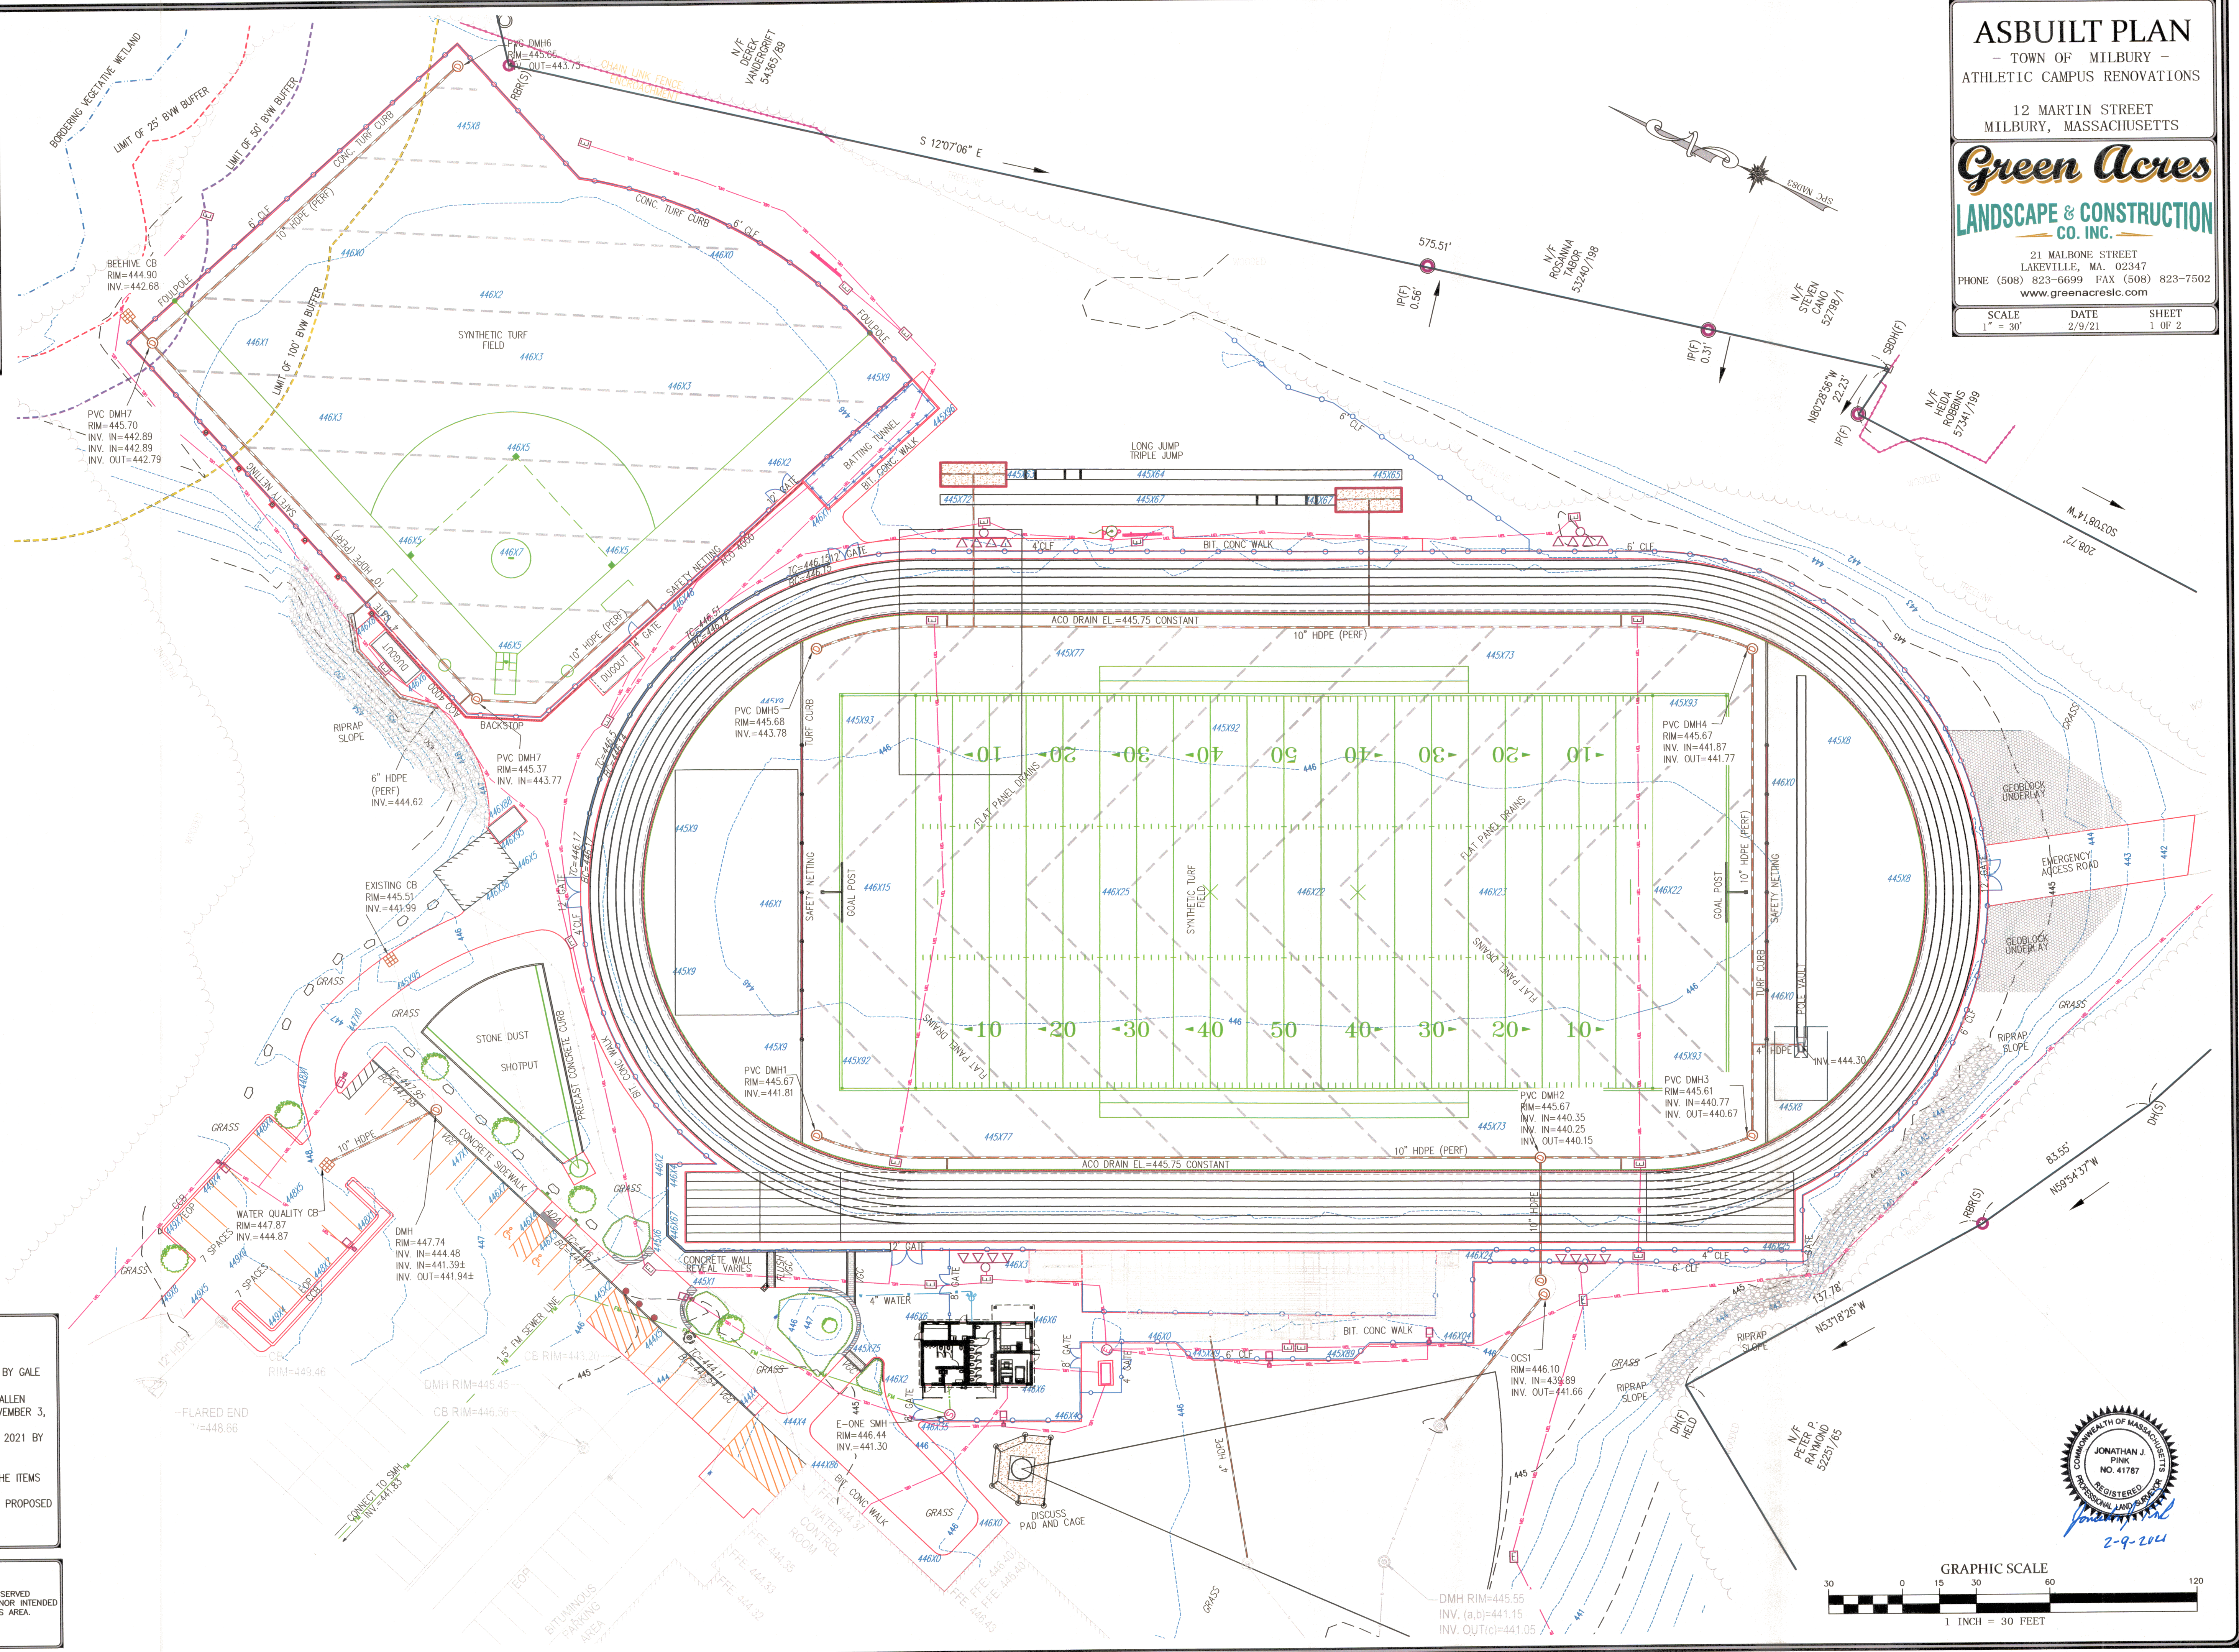

- PLAN REFERENCES**
1. "ATHLETIC CAMPUS RENOVATIONS"; PREPARED BY GALE ASSOCIATES, INC.; DATED JUNE 6, 2020
  2. "PLAN OF LAND IN MILBURY"; PREPARED BY ALLEN ENGINEERING & ASSOCIATES, INC.; DATED NOVEMBER 3, 2020.
  3. ASBUILT SURVEY COMPLETED ON JANUARY 8, 2021 BY AN "ON THE GROUND" SURVEY.
  4. CERTIFICATION OF THIS PLAN IS FOR ASBUILT ELEVATIONS, LOCATIONS AND MATERIALS OF THE ITEMS SHOWN IN COLOR WHICH HAS BEEN BUILT IN SUBSTANTIAL COMPLIANCE AS SHOWN AS THE PROPOSED WORK IN PLAN REFERENCE #1.

**NOTES:**  
 LOCATION OF UTILITIES SHOWN HEREON ARE FROM OBSERVED EVIDENCE AND RECORD PLANS. THIS IS NOT IMPLIED NOR INTENDED TO BE THE COMPLETE INVENTORY OF UTILITIES IN THIS AREA.  
 HORIZONTAL DATUM: SPC NAD83  
 VERTICAL DATUM: NAVD 88

**GRAPHIC SCALE**

1 INCH = 30 FEET

Professional Engineer Seal:  
 COMMONWEALTH OF MASSACHUSETTS  
 JONATHAN J. PINK  
 NO. 41787  
 REGISTERED PROFESSIONAL LAND SURVEYOR  
 2-9-2021



